


These Record Documents have been prepared based on information (marked-up prints, drawings and other data) provided to the Architect by the Contractor. The Architect has not verified the accuracy and/or completeness of this information and shall not be responsible for the errors or omissions which may be incorporated herein as a result.








AS-BUILTS

Area Key Plan

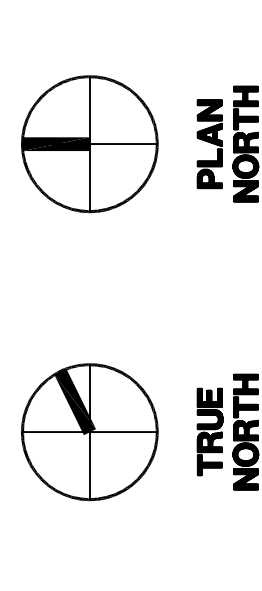

Scale: 1/8" = 1'-0"

Falcon High School No. 3 Project No. 05-0233

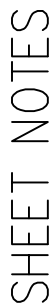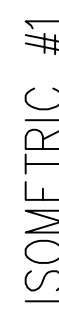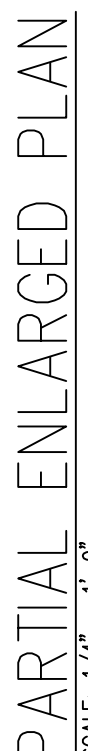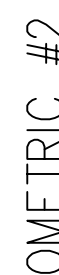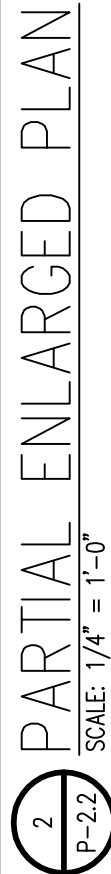

SENSOR OPERATED FLUSH VALVES/FAUCETS
120 VOLT HARDWARE TO TRANSFORMERS
SEE FLOOR PLANS FOR EXACT LOCATION
OF TRANSFORMERS

RECOMMENDATIONS FOR PLUMBING EQUIPMENT
REQUIRING ELECTRICAL SERVICE

06 NOV 78 09 10Z

TO BE PROVIDED AND INSTALLED BY E.C., P.C. TO COORDINATE EXACT QUANTITY AND LOCATION, P.C. PROVIDE AND INSTALL LOW VOLTAGE WIRING

TRANSFORMER OF THE SPECIFIED MANUFACTURER
MODEL NUMBER SERVES UP TO (10) OF THE SPECIFIED
FACTURER AND MODEL NUMBER WATER CLOSET
AND URINAL FLUSHMETERS

TRANSFORMER OF THE SPECIFIED MANUFACTURER
MODEL NUMBER SERVES UP TO (6) OF THE SPECIFIED
MANUFACTURER AND MODEL NUMBER LAVATORY FAUCET